



LEGEND:

CWD	COLD WATER PIPE
HWP	HOT WATER PIPE
	GATE VALVE
	CHECK VALVE
WH	WATER STORAGE HEATER
Ht	HOSE TAP
Bt	BIB TAP
Bs	BIDET SPRAY
WM	WASHING MACHINE
wb	WASH BASIN
wc	WATER CLOSET
sh	SHOWER
sk	SINK

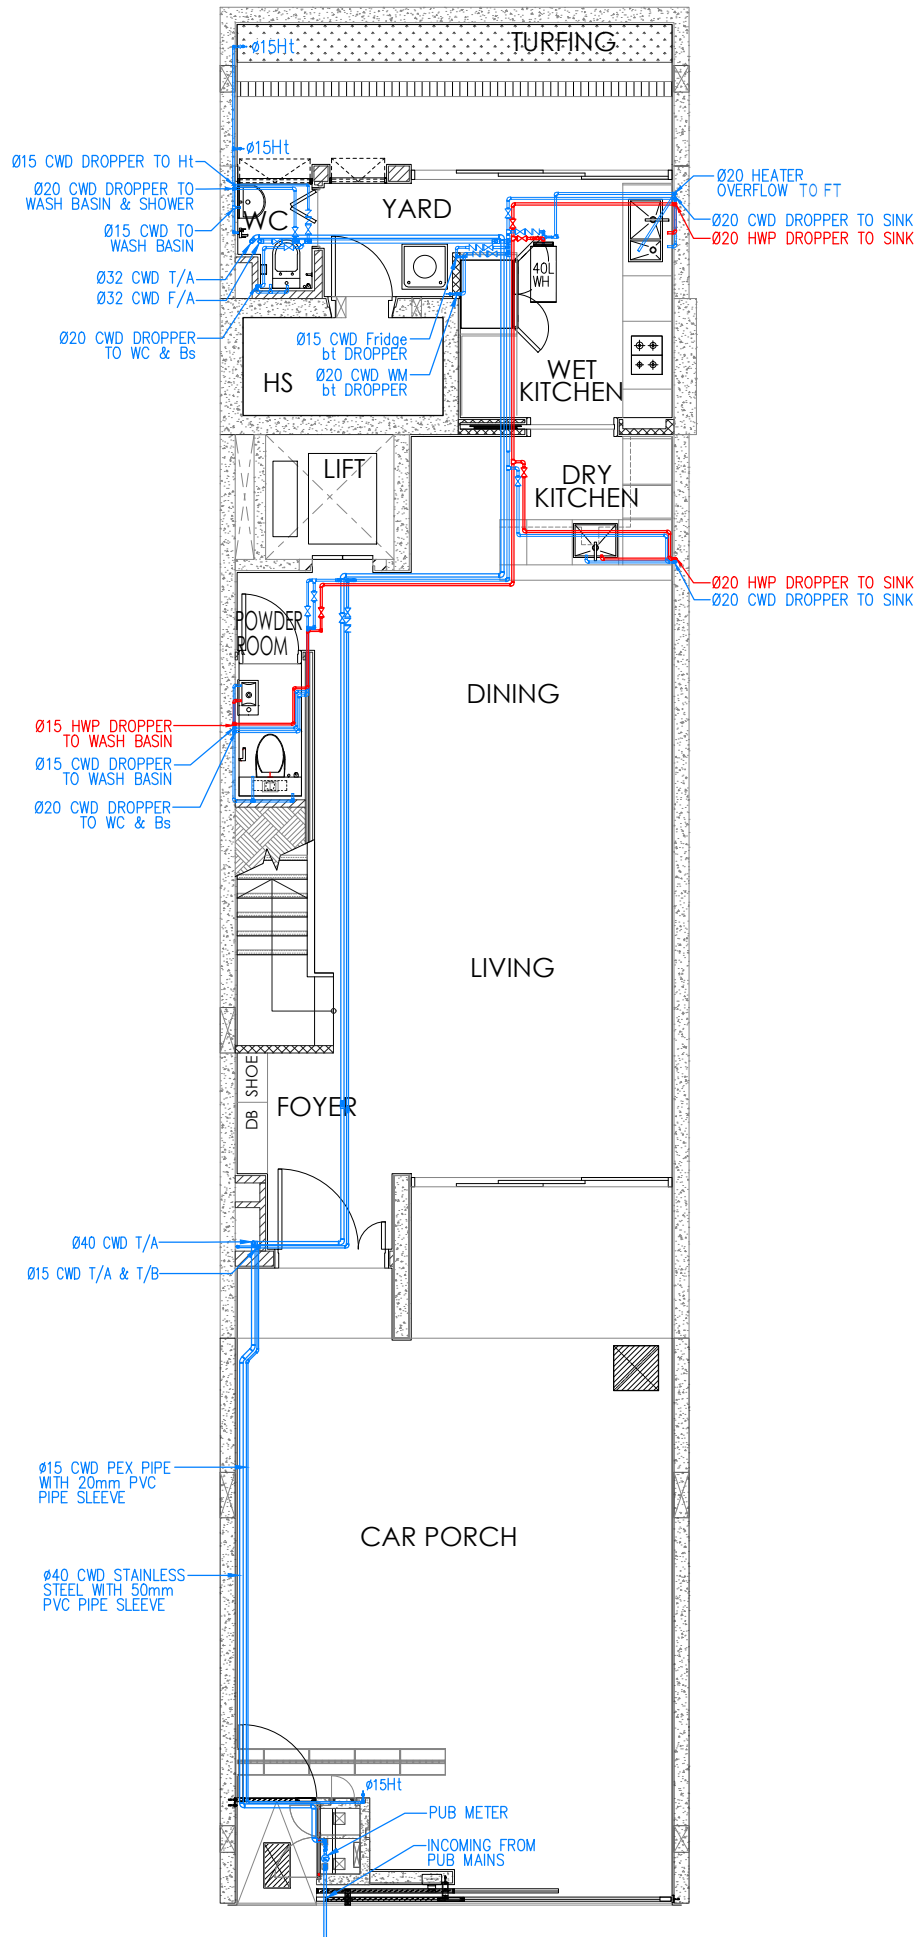


LEGEND:

CWD	COLD WATER PIPE
HWP	HOT WATER PIPE
	GATE VALVE
	CHECK VALVE
WH	WATER STORAGE HEATER
Ht	HOSE TAP
Bt	BIB TAP
Bs	BIDET SPRAY
WM	WASHING MACHINE
wb	WASH BASIN
wc	WATER CLOSET
sh	SHOWER
sk	SINK

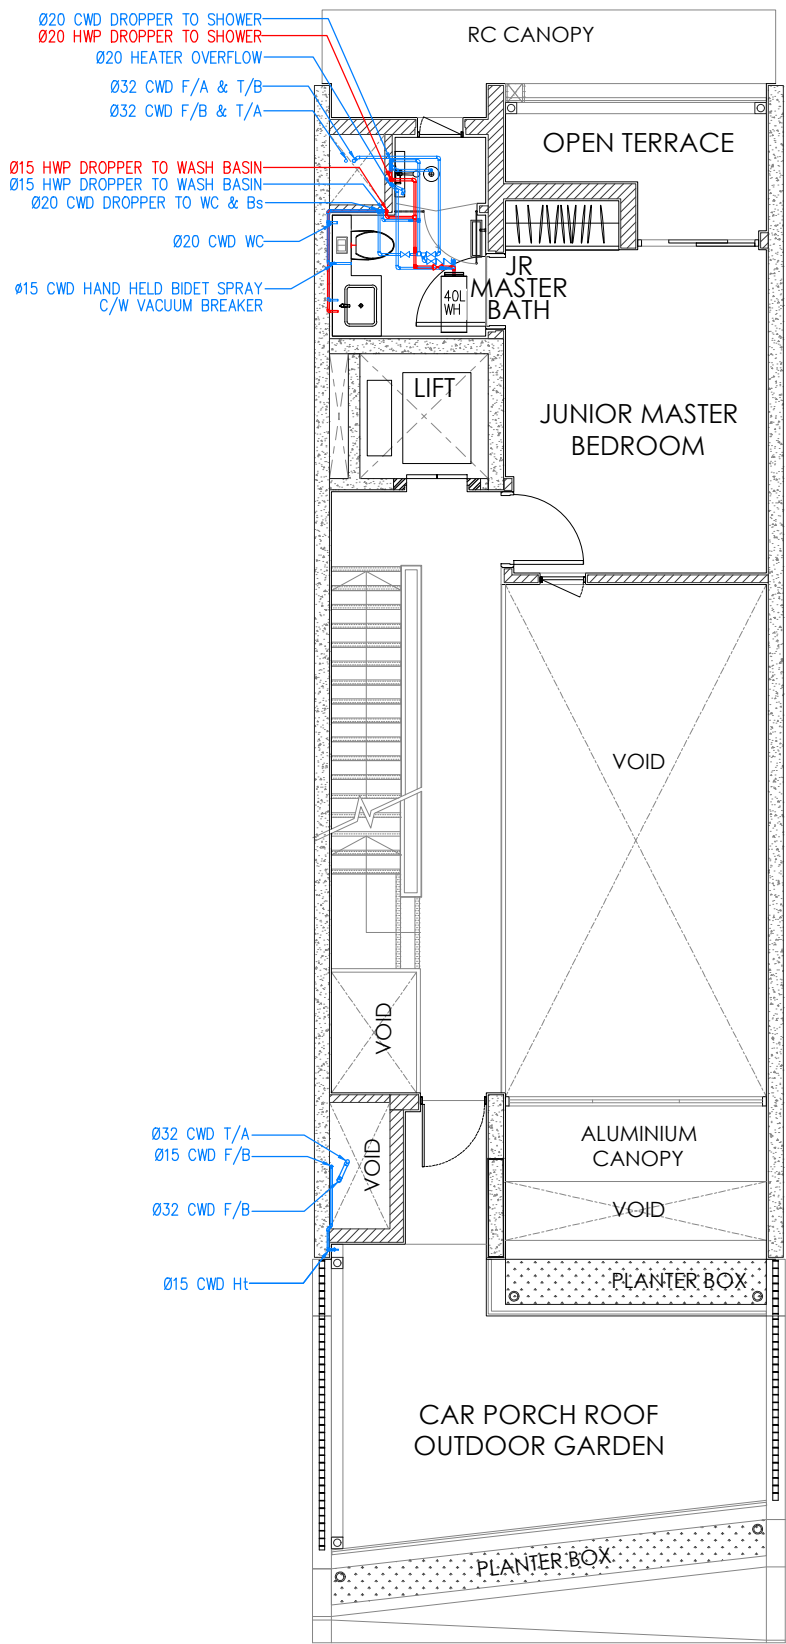


LEGEND:

— CWD	COLD WATER PIPE
- - - HWP	HOT WATER PIPE
	GATE VALVE
	CHECK VALVE
	WATER STORAGE HEATER
Ht	HOSE TAP
Bt	BIB TAP
Bs	BIDET SPRAY
WM	WASHING MACHINE
wb	WASH BASIN
wc	WATER CLOSET
sh	SHOWER
sk	SINK

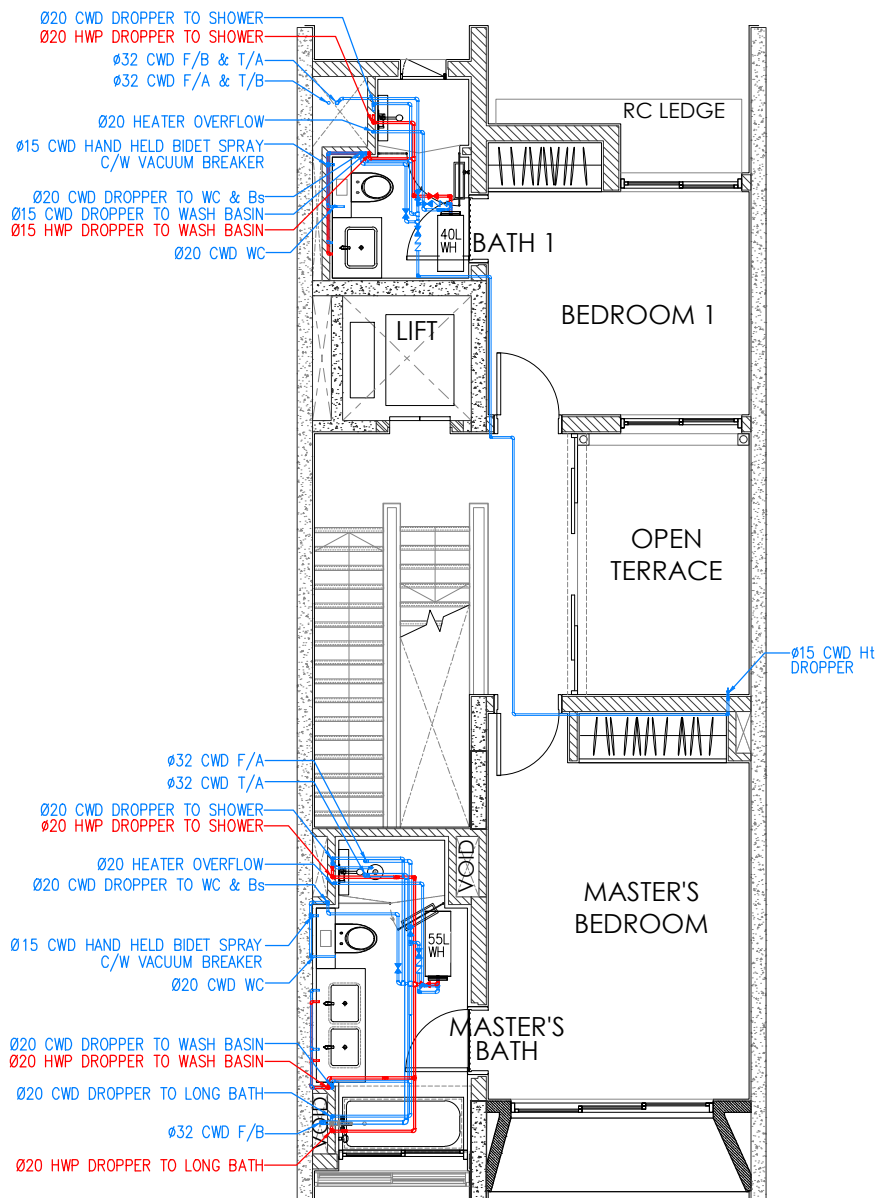

LEGEND:

— CWD	COLD WATER PIPE
- - - HWP	HOT WATER PIPE
	GATE VALVE
	CHECK VALVE
	WATER STORAGE HEATER
Ht	HOSE TAP
Bt	BIB TAP
Bs	BIDET SPRAY
WM	WASHING MACHINE
wb	WASH BASIN
wc	WATER CLOSET
sh	SHOWER
sk	SINK

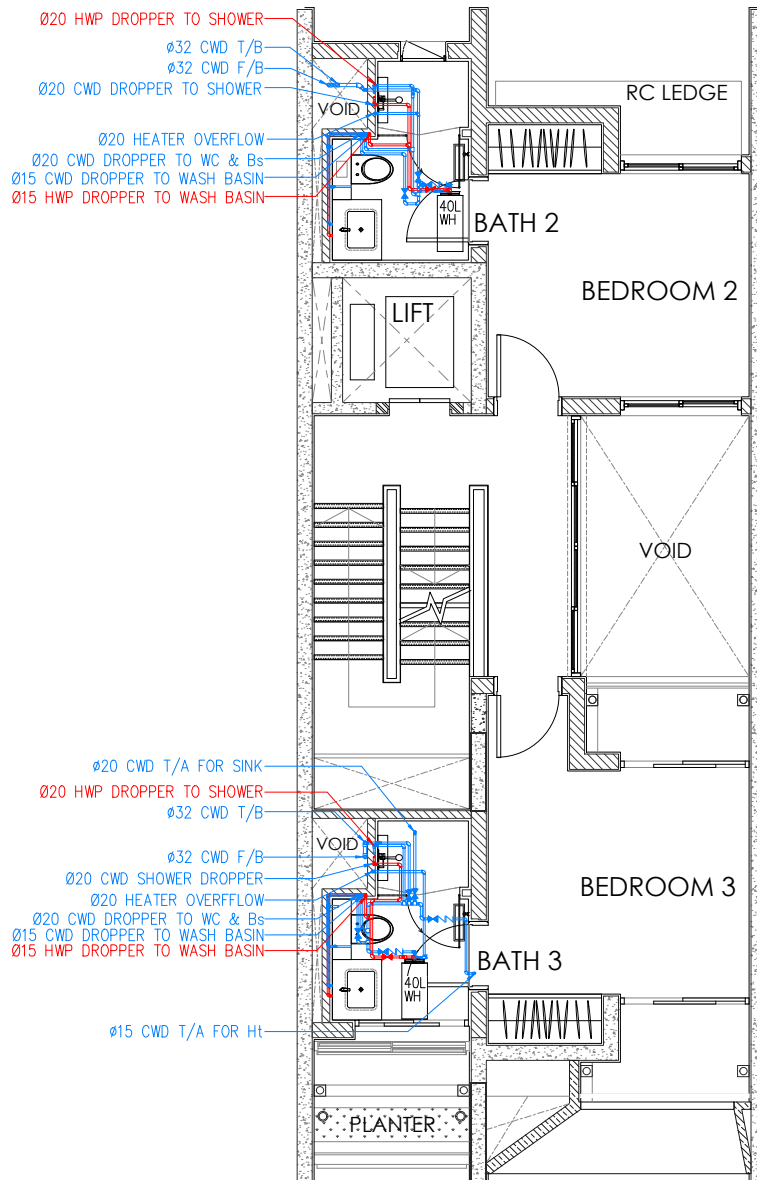

LEGEND:

CWD	COLD WATER PIPE
HWP	HOT WATER PIPE
	GATE VALVE
	CHECK VALVE
WH	WATER STORAGE HEATER
Ht	HOSE TAP
Bt	BIB TAP
Bs	BIDET SPRAY
WM	WASHING MACHINE
wb	WASH BASIN
wc	WATER CLOSET
sh	SHOWER
sk	SINK

