



# LEGEND :

|             |                                                          |
|-------------|----------------------------------------------------------|
| SWP/SWVP/WP | SOIL WASTE PIPE /<br>SOIL WASTE VENT PIPE/<br>WASTE PIPE |
| VP          | VENT PIPE                                                |
| FW          | FLOOR WASTE                                              |
| FT          | FLOOR TRAP                                               |
| SFT         | SHALLOW FLOOR TRAP                                       |
| wm          | WASHING MACHINE                                          |
| sk          | SINK                                                     |
| wb          | WASH BASIN                                               |
| wc          | WATER CLOSET                                             |
| B/D         | BACKDROP                                                 |
| F/B         | FROM BELOW                                               |
| F/A         | FROM ABOVE                                               |
| T/A         | TO ABOVE                                                 |
| T/B         | TO BELOW                                                 |
| H/L         | HIGH LEVEL                                               |

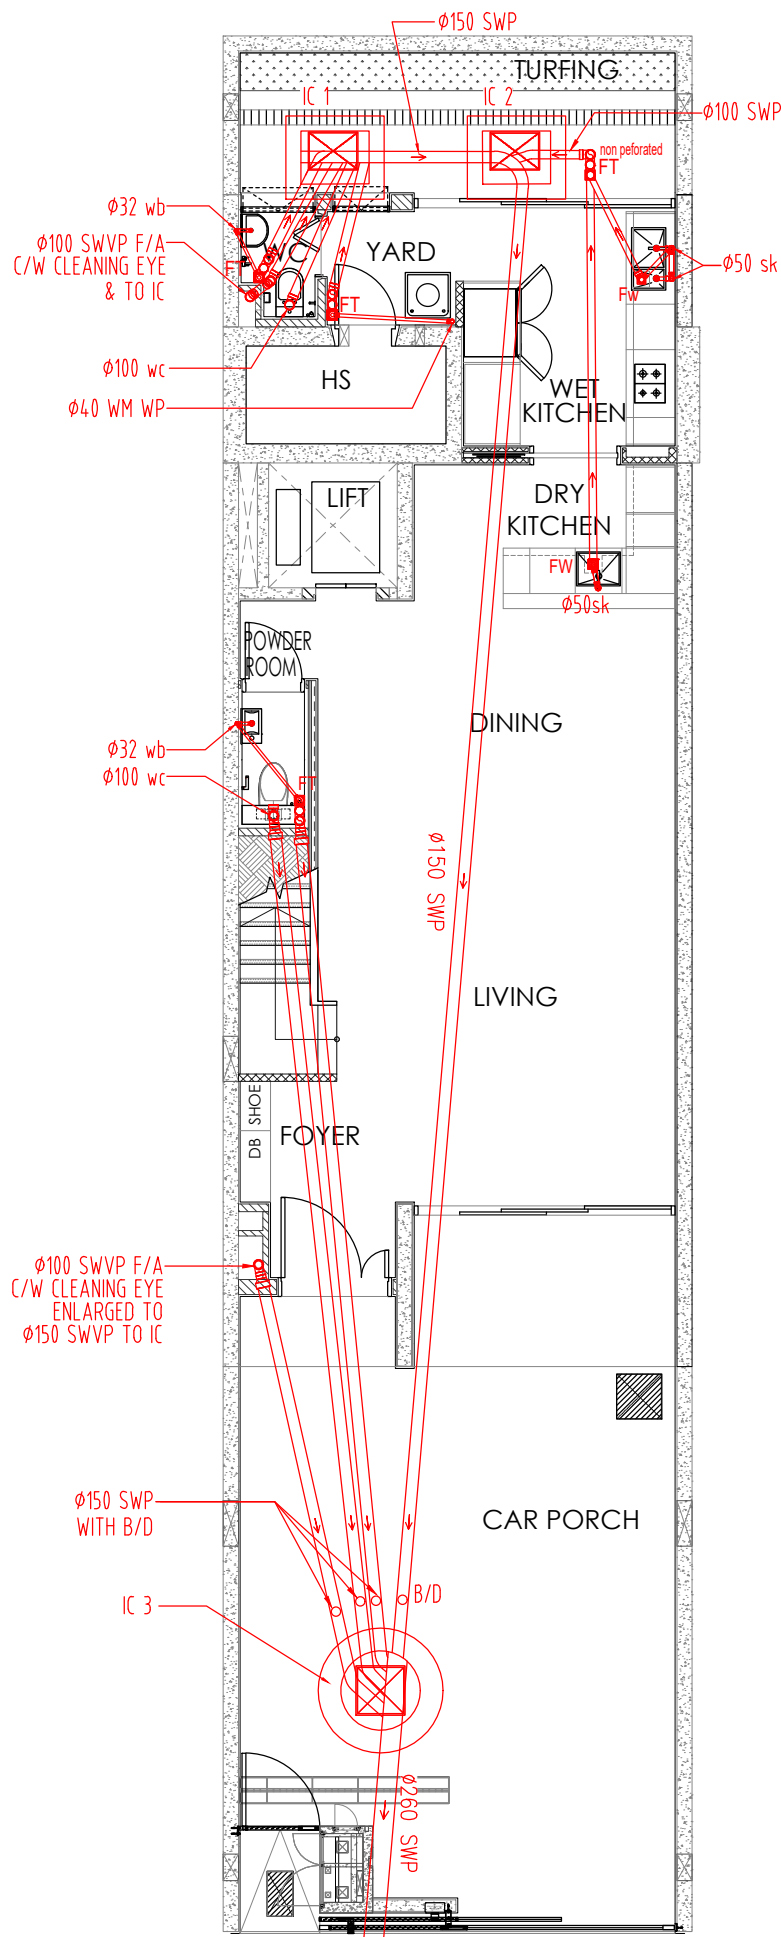


| LEGEND :      |                                                          |
|---------------|----------------------------------------------------------|
| SWP /SWVP /WP | SOIL WASTE PIPE /<br>SOIL WASTE VENT PIPE/<br>WASTE PIPE |
| VP            | VENT PIPE                                                |
| FW            | FLOOR WASTE                                              |
| FT            | FLOOR TRAP                                               |
| SFT           | SHALLOW FLOOR TRAP                                       |
| wm            | WASHING MACHINE                                          |
| sk            | SINK                                                     |
| wb            | WASH BASIN                                               |
| wc            | WATER CLOSET                                             |
| B/D           | BACKDROP                                                 |
| F/B           | FROM BELOW                                               |
| F/A           | FROM ABOVE                                               |
| T/A           | TO ABOVE                                                 |
| T/B           | TO BELOW                                                 |
| H/L           | HIGH LEVEL                                               |

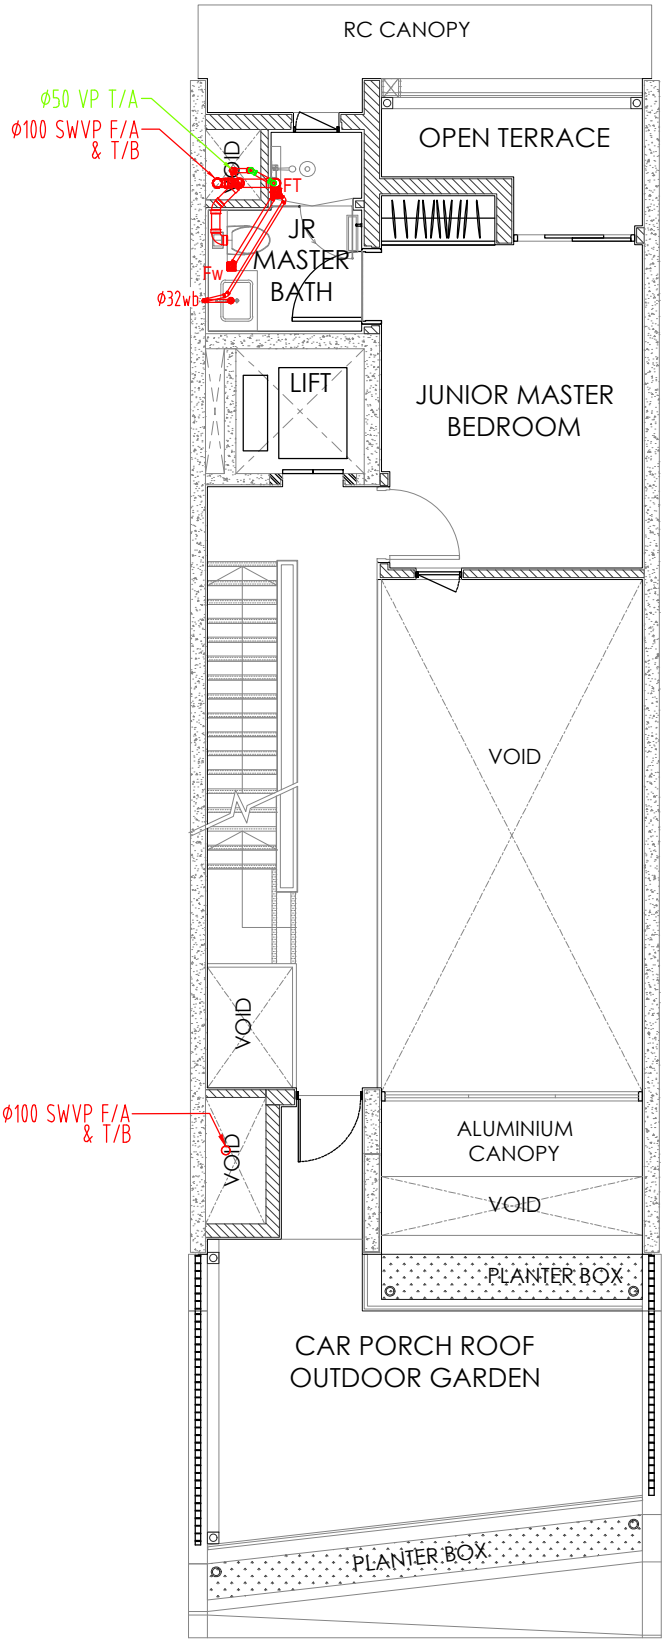


## LEGEND :

|                                                                                     |                                                          |
|-------------------------------------------------------------------------------------|----------------------------------------------------------|
| <u>SWP /SWVP /WP</u>                                                                | SOIL WASTE PIPE /<br>SOIL WASTE VENT PIPE/<br>WASTE PIPE |
| <u>VP</u>                                                                           | VENT PIPE                                                |
|  | FW<br>FLOOR WASTE                                        |
|  | FT<br>FLOOR TRAP                                         |
| SFT                                                                                 | SHALLOW FLOOR TRAP                                       |
| wm                                                                                  | WASHING MACHINE                                          |
| sk                                                                                  | SINK                                                     |
| wb                                                                                  | WASH BASIN                                               |
| wc                                                                                  | WATER CLOSET                                             |
| B/D                                                                                 | BACKDROP                                                 |
| F/B                                                                                 | FROM BELOW                                               |
| F/A                                                                                 | FROM ABOVE                                               |
| T/A                                                                                 | TO ABOVE                                                 |
| T/B                                                                                 | TO BELOW                                                 |
| H/L                                                                                 | HIGH LEVEL                                               |

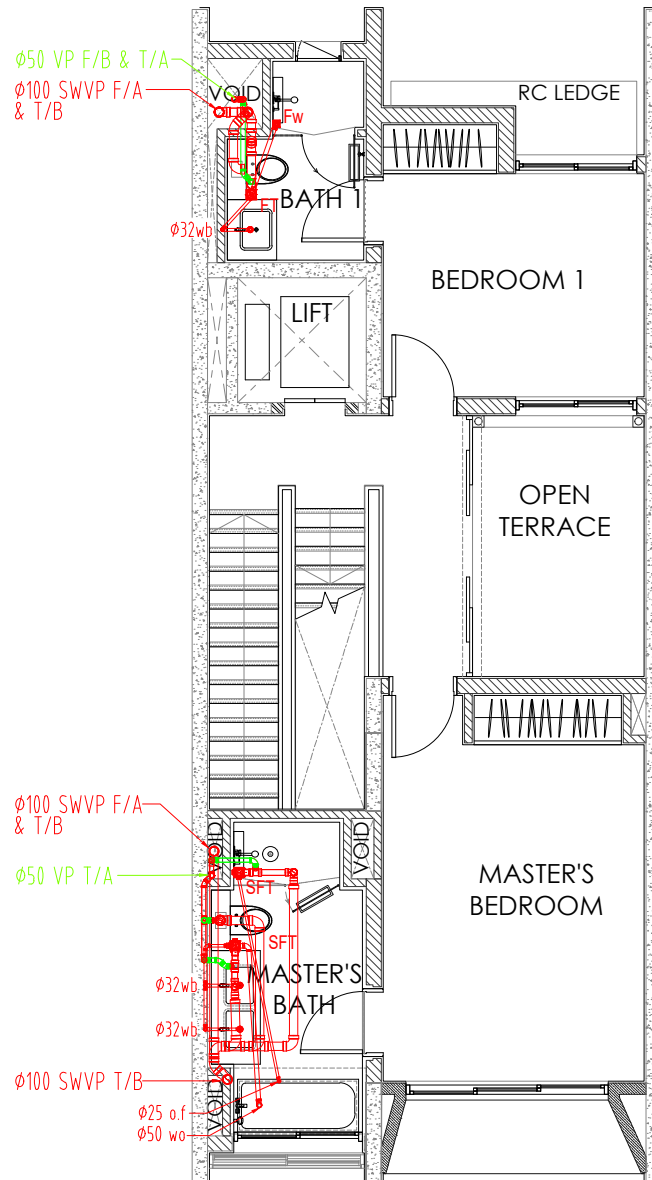


# LEGEND :

|               |                                                          |
|---------------|----------------------------------------------------------|
| SWP /SWVP /WP | SOIL WASTE PIPE /<br>SOIL WASTE VENT PIPE/<br>WASTE PIPE |
| VP            | VENT PIPE                                                |
| FW            | FLOOR WASTE                                              |
| FT            | FLOOR TRAP                                               |
| SFT           | SHALLOW FLOOR TRAP                                       |
| wm            | WASHING MACHINE                                          |
| sk            | SINK                                                     |
| wb            | WASH BASIN                                               |
| wc            | WATER CLOSET                                             |
| B/D           | BACKDROP                                                 |
| F/B           | FROM BELOW                                               |
| F/A           | FROM ABOVE                                               |
| T/A           | TO ABOVE                                                 |
| T/B           | TO BELOW                                                 |
| H/L           | HIGH LEVEL                                               |

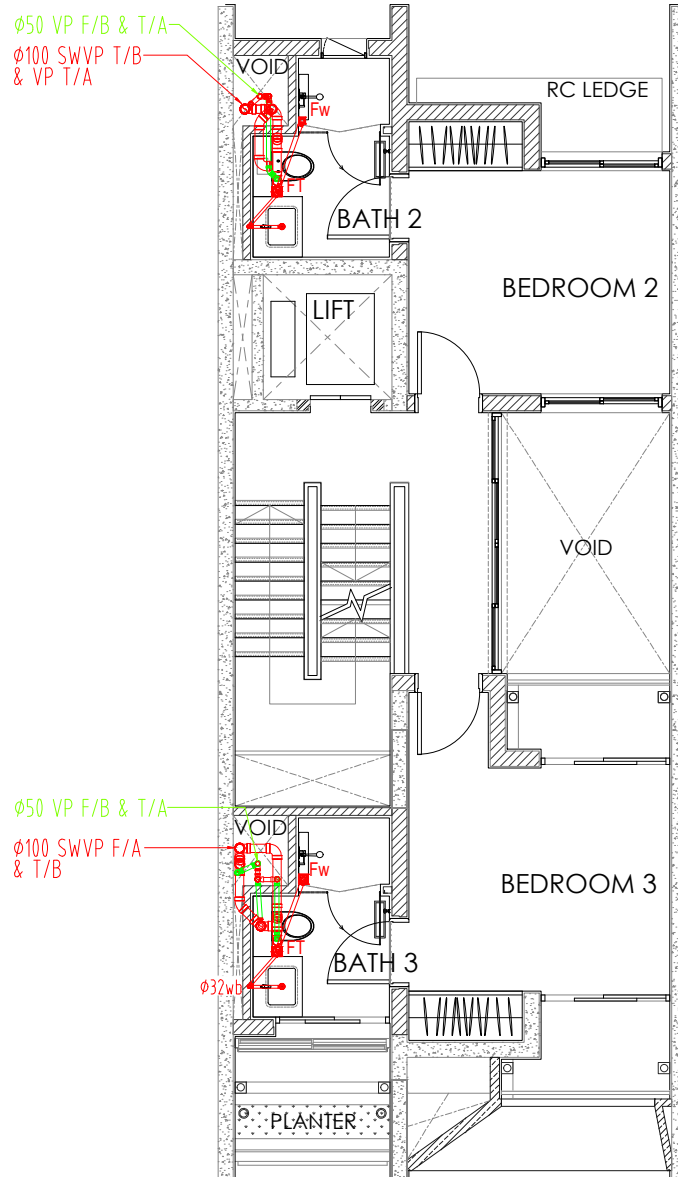

# LEGEND :

|                                                                                     |                                                          |
|-------------------------------------------------------------------------------------|----------------------------------------------------------|
| <u>SWP /SWVP /WP</u>                                                                | SOIL WASTE PIPE /<br>SOIL WASTE VENT PIPE/<br>WASTE PIPE |
| <u>VP</u>                                                                           | VENT PIPE                                                |
|  | FW<br>FLOOR WASTE                                        |
|  | FT<br>FLOOR TRAP                                         |
| SFT                                                                                 | SHALLOW FLOOR TRAP                                       |
| wm                                                                                  | WASHING MACHINE                                          |
| sk                                                                                  | SINK                                                     |
| wb                                                                                  | WASH BASIN                                               |
| wc                                                                                  | WATER CLOSET                                             |
| B/D                                                                                 | BACKDROP                                                 |
| F/B                                                                                 | FROM BELOW                                               |
| F/A                                                                                 | FROM ABOVE                                               |
| T/A                                                                                 | TO ABOVE                                                 |
| T/B                                                                                 | TO BELOW                                                 |
| H/L                                                                                 | HIGH LEVEL                                               |

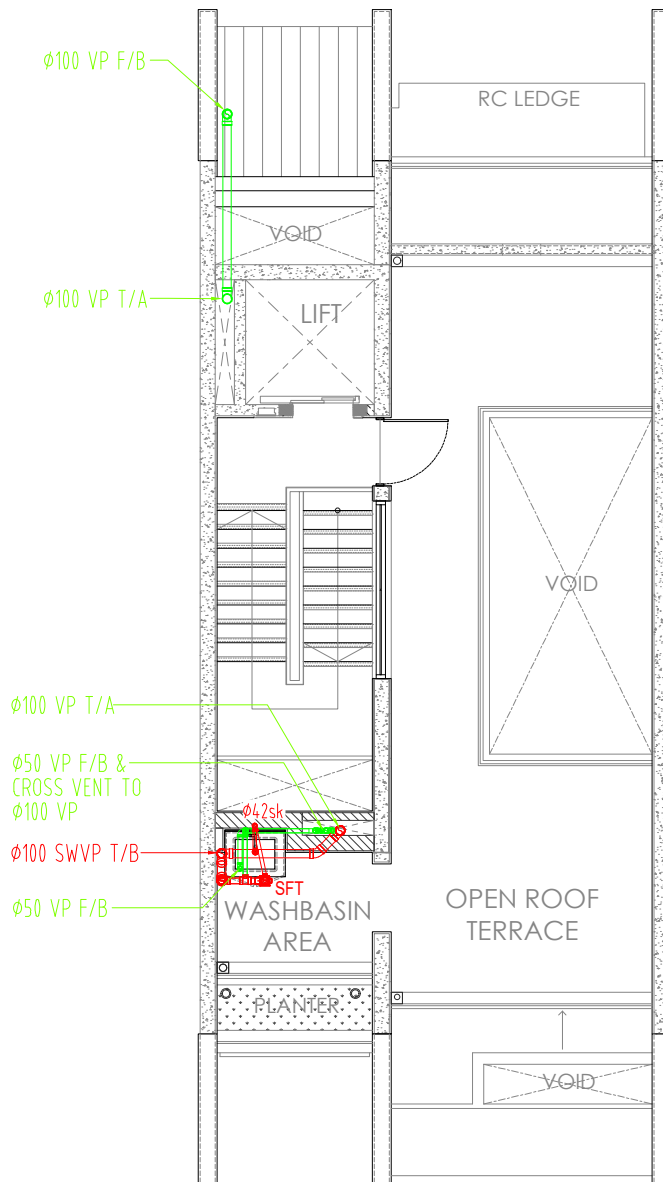

**LEGEND :**

|                                                                                        |                                                          |
|----------------------------------------------------------------------------------------|----------------------------------------------------------|
| <u>SWP /SWVP /WP</u>                                                                   | SOIL WASTE PIPE /<br>SOIL WASTE VENT PIPE/<br>WASTE PIPE |
| <u>VP</u>                                                                              | VENT PIPE                                                |
|  FW | FLOOR WASTE                                              |
|  FT | FLOOR TRAP                                               |
| SFT                                                                                    | SHALLOW FLOOR TRAP                                       |
| wm                                                                                     | WASHING MACHINE                                          |
| sk                                                                                     | SINK                                                     |
| wb                                                                                     | WASH BASIN                                               |
| wc                                                                                     | WATER CLOSET                                             |
| B/D                                                                                    | BACKDROP                                                 |
| F/B                                                                                    | FROM BELOW                                               |
| F/A                                                                                    | FROM ABOVE                                               |
| T/A                                                                                    | TO ABOVE                                                 |
| T/B                                                                                    | TO BELOW                                                 |
| H/L                                                                                    | HIGH LEVEL                                               |

